
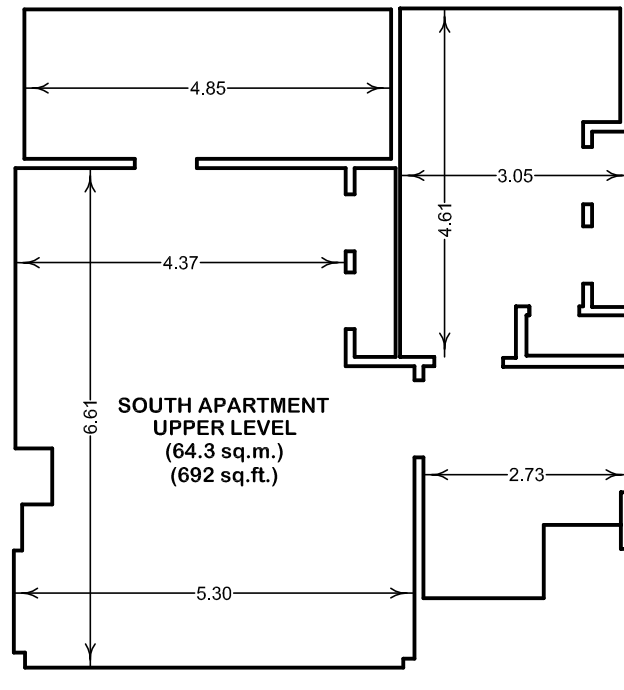



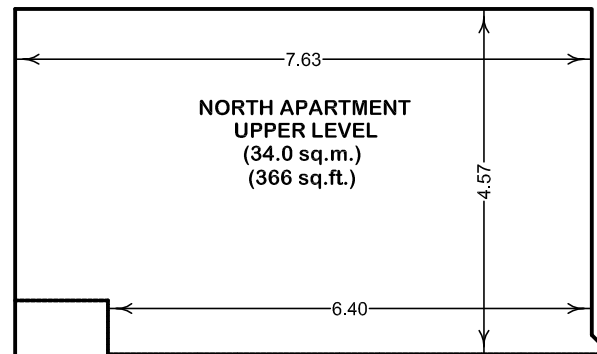
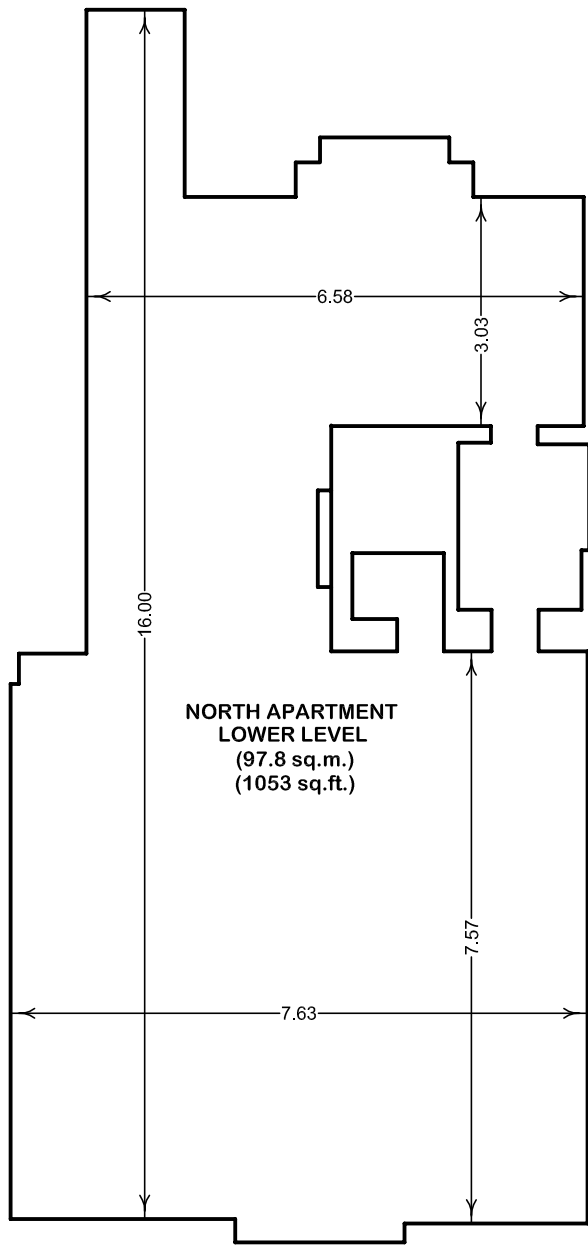
ASBUILT PLAN OF
SOUTH APARTMENT OF
17 YORKVILLE AVENUE
 CITY OF TORONTO

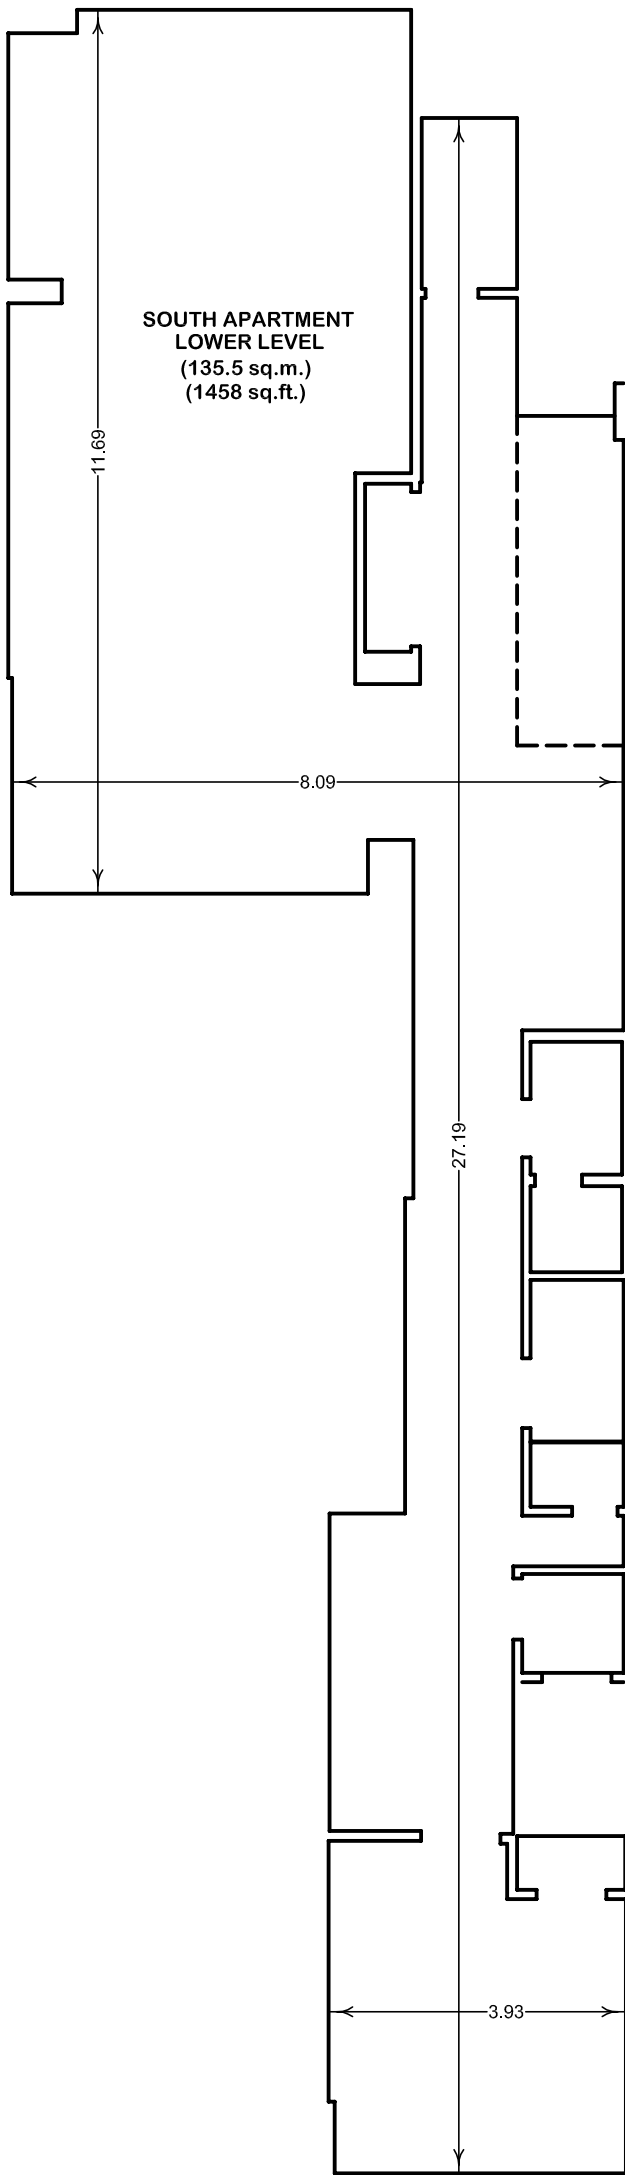

NOT TO SCALE
 WSP GEOMATICS ONTARIO LIMITED
 ONTARIO LAND SURVEYORS
 2017 © This plan is protected by copyright.

	WSP Geomatics Ontario Limited	Ontario Land Surveyors	Drawing Number :
			17M-01494-002
610 Chartwell Road, Suite 300, Oakville, Ontario Canada, L6J 4A5 t: 905-823-8500 f: 905-823-8503			Website : www.wspgroup.ca
P.Chief: A.K.	Dwg. By: C.E.W.	Chk'd by: G.M.	
Job Number: 17M-01494-00-AV1	Dwg File Name:		Tab Name: 11 x 17 (2)
			17 YORKVILLE.DWG

ASBUILT PLAN OF
NORTH APARTMENT OF
17 YORKVILLE AVENUE
 CITY OF TORONTO



NOT TO SCALE
 WSP GEOMATICS ONTARIO LIMITED
 ONTARIO LAND SURVEYORS
 2017 © This plan is protected by copyright.

WSP Geomatics Ontario Limited	Ontario Land Surveyors	Drawing Number : 17M-01494-001
610 Chartwell Road, Suite 300, Oakville, Ontario Canada, L6J 4A5 t: 905-823-8500 f: 905-823-8503		Website : www.wspgroup.ca
P.Chief : A.K.	Dwg. By : C.E.W.	Chk'd by : G.M.
Job Number : 17M-01494-00-AV1		Tab Name: 11 x 17
Dwg File Name:		17 YORKVILLE.DWG